

PSM178120
 E: 504738.207
 N: 7043356.101
 RL: 17.324m




BRAD THOMPSON ENGINEERS CERTIFICATION
 I, BRAD THOMPSON, hereby certify that:
 1. The information contained in this drawing / document is in compliance with approved drawings and design.
 2. The new water and sewerage works defined by this drawing have been designed and constructed in accordance with the SEQ code.
 3. This represents an accurate record of as-constructed works.
 4. I accept responsibility for the information contained in this drawing / document. In accepting this responsibility we have relied upon information provided by others.
CERTIFICATION FOR HARMONY RELEASE 7
 RPEQ Signature: *[Signature]* RPEQ No. 07818 Date 01.11.18
 For and on behalf of CALIBRE CONSULTING (QLD) PTY LTD.



- LEGEND**
- EXISTING WATER MAIN
 - WATER MAIN (100 PVC-O PN16)
 - WATER MAIN (200 PVC-O PN16)
 - SERVICE PIPE (25 PE100 PN16)
 - CONDUIT PIPE (100 PVC-U PN9)
 - WATER METER - 20mm ELSTER
 - FIRE HYDRANT
 - FITTING
 - SLUICE VALVE

Registered Surveyor's certification
 I, Andrew Cridland, hereby certify that the vertical and horizontal locations, and dimensions shown on this plan are a true and correct record and were located by survey.
[Signature]
 Registered Surveyor Reg Surveyor No.3361 Date 03/10/2018

COORDINATE DATUM NOTE:
 HORIZONTAL COORDINATES(E,N) SUPPLIED ARE MAPPING GRID OF AUSTRALIA(MGA), ZONE 56 BASED ON THE UNIVERSAL TRANSVERSE MERCATOR PROJECTION AND THE GEOCENTRIC DATUM OF AUSTRALIA 1994.
 HORIZONTAL DATUM DERIVED FROM PSM178120, E 504738.207, N 7043356.101.
 LEVELS SUPPLIED ARE ON THE AUSTRALIAN HEIGHT DATUM(AHD)
 LEVEL DATUM DERIVED FROM PSM178120 RL 17.324 (AHD)

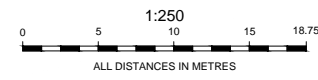

A1	INDEX	DATE	REVISIONS	DRAWN	CHECKED	PASSED	INITIALS	DATE
	A	03/10/2018	As-constructed details	JG	LG			



CONSULT AUSTRALIA
 Calibre Consulting (QLD) Pty Ltd
 Level 3, 16 Innovation Parkway, Brisbane QLD Australia 4575
 Telephone 07 5314 2520 Facsimile 07 5314 2522
 Brisbane Canberra Melbourne Sydney Singapore Sunshine Coast




Unitywater
 UW2018011877
 AS-CONSTRUCTED WATER RETICULATION
 HARMONY ESTATE RELEASE 7

SHEET 1 OF 4 SHEETS	SCALE 1:250
REVISION DATE 03/10/2018	REVISION A
DISCIPLINE CODE	
DRAWING NO.	

PSM178120
E: 504.738.207
N: 704.3356.101
RL: 17.324m



BRAD THOMPSON ENGINEERS CERTIFICATION
 1. I, BRAD THOMPSON, hereby certify that:
 2. The information contained in this drawing / document is in compliance with approved drawings and design.
 3. The new water and sewerage works defined by this drawing have been designed and constructed in accordance with the SEQ code.
 4. This represents an accurate record of as-constructed works.
 I accept responsibility for the information contained in this drawing / document. In accepting this responsibility we have relied upon information provided by others.
 CERTIFICATION FOR HARMONY RELEASE 7
 RPEQ Signature: *[Signature]* RPEQ No. 07818 Date 01.11.18
 For and on behalf of CALIBRE CONSULTING (QLD) PTY LTD.

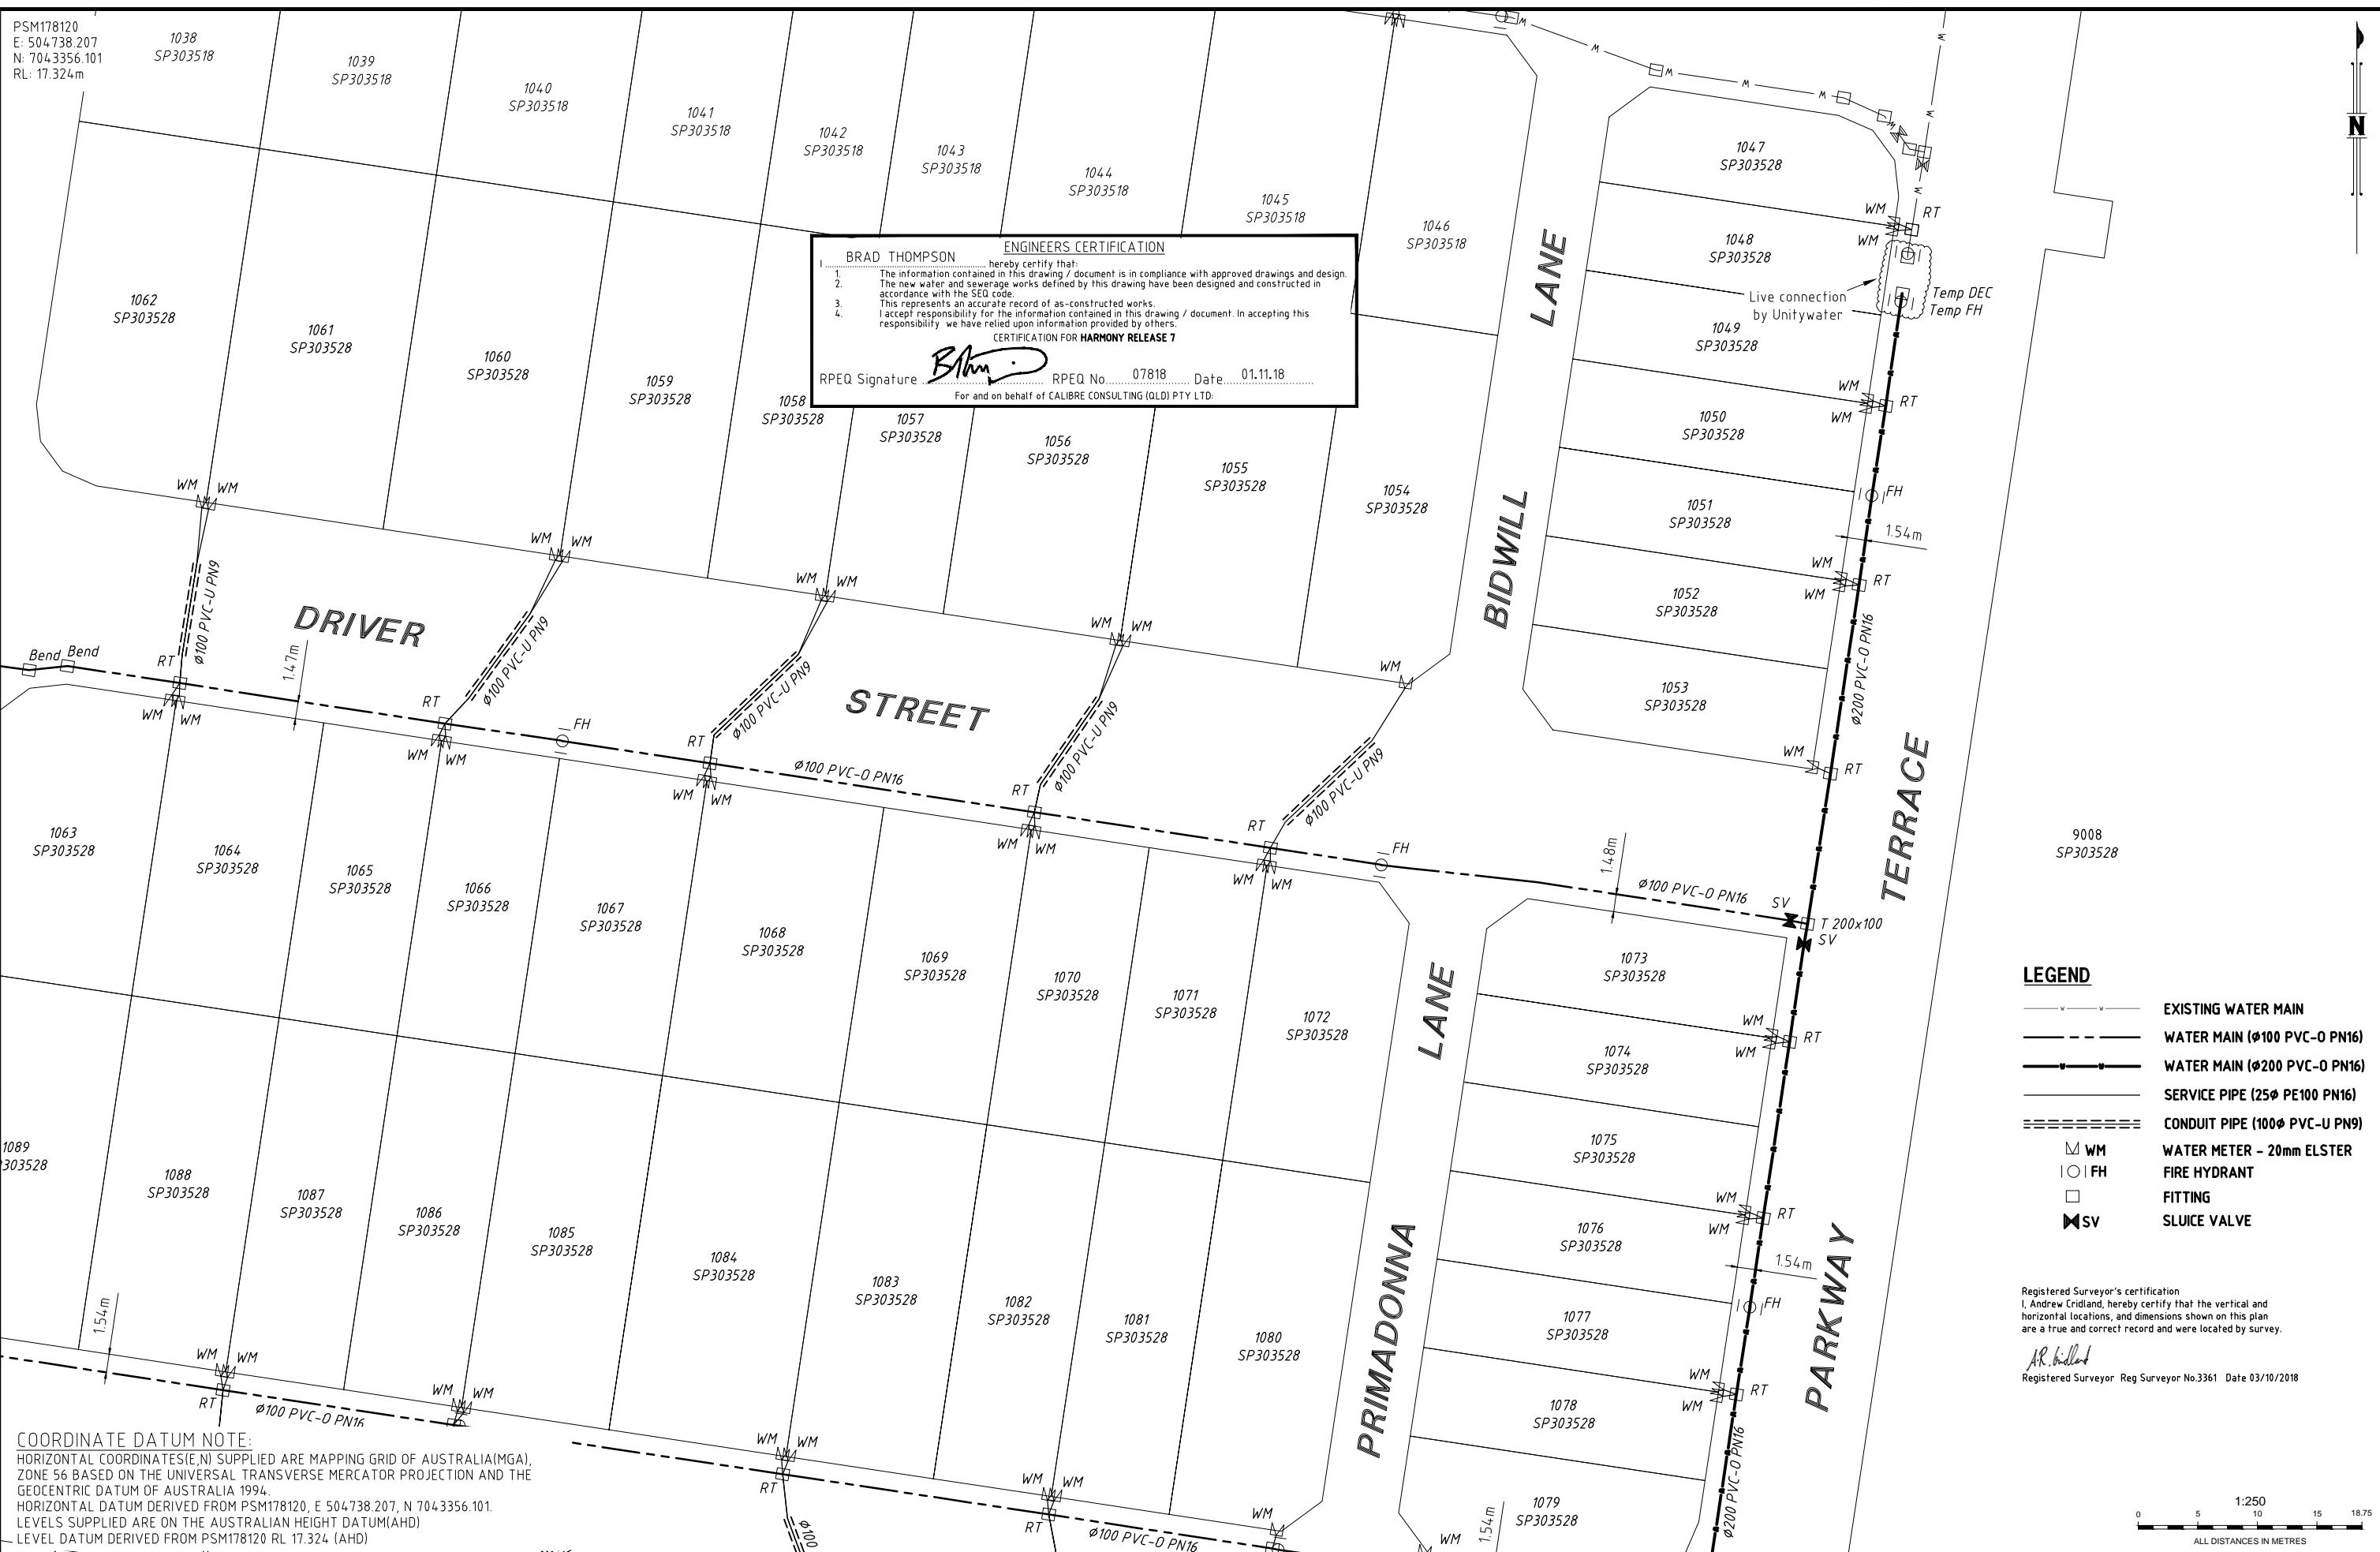


LEGEND

	EXISTING WATER MAIN
	WATER MAIN (Ø100 PVC-O PN16)
	WATER MAIN (Ø200 PVC-O PN16)
	SERVICE PIPE (25Ø PE100 PN16)
	CONDUIT PIPE (100Ø PVC-U PN9)
	WATER METER - 20mm ELSTER
	FIRE HYDRANT
	FITTING
	SLUCE VALVE

Registered Surveyor's certification
 I, Andrew Cridland, hereby certify that the vertical and horizontal locations, and dimensions shown on this plan are a true and correct record and were located by survey.
[Signature]
 Registered Surveyor: Reg Surveyor No.3361 Date 03/10/2018

COORDINATE DATUM NOTE:
 HORIZONTAL COORDINATES(E,N) SUPPLIED ARE MAPPING GRID OF AUSTRALIA(MGA), ZONE 56 BASED ON THE UNIVERSAL TRANSVERSE MERCATOR PROJECTION AND THE GEOCENTRIC DATUM OF AUSTRALIA 1994.
 HORIZONTAL DATUM DERIVED FROM PSM178120, E 504.738.207, N 704.3356.101.
 LEVELS SUPPLIED ARE ON THE AUSTRALIAN HEIGHT DATUM(AHD)
 LEVEL DATUM DERIVED FROM PSM178120 RL 17.324 (AHD)

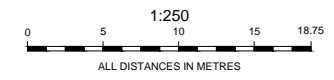

A1	INDEX	DATE	REVISIONS	DRAWN	CHECKED	PASSED	INITIALS	DATE	
	A	03/10/2018	As-constructed details	JG	LG				
	DRAWN	JG	03/10/2018	CHECKED	LG	03/10/2018	PASSED	GB	03/10/2018

CONSULT AUSTRALIA
 Calibre Consulting (QLD) Pty Ltd
 Level 3, 16 Innovation Parkway, Brisbane QLD Australia 4575
 Telephone 07 5314 2520 Facsimile 07 5314 2522
 Brisbane Canberra Melbourne Sydney Singapore Sunshine Coast



Unitywater
 UW2018011877
 AS-CONSTRUCTED WATER RETICULATION
 HARMONY ESTATE RELEASE 7

SHEET 2 OF 4 SHEETS	SCALE 1:250
REVISION DATE 03/10/2018	REVISION A
DISCIPLINE CODE	
DRAWING NO.	

PSM178120
 E: 504.738.207
 N: 704.3356.101
 RL: 17.324m




BRAD THOMPSON ENGINEERS CERTIFICATION
 I, BRAD THOMPSON, hereby certify that:
 1. The information contained in this drawing / document is in compliance with approved drawings and design.
 2. The new water and sewerage works defined by this drawing have been designed and constructed in accordance with the SEQ code.
 3. This represents an accurate record of as-constructed works.
 4. I accept responsibility for the information contained in this drawing / document. In accepting this responsibility we have relied upon information provided by others.
 CERTIFICATION FOR HARMONY RELEASE 7
 RPEQ Signature: *Brad Thompson* RPEQ No: 07818 Date: 01.11.18
 For and on behalf of CALIBRE CONSULTING (QLD) PTY LTD.

- LEGEND**
- EXISTING WATER MAIN
 - WATER MAIN (Ø100 PVC-U PN16)
 - WATER MAIN (Ø200 PVC-U PN16)
 - SERVICE PIPE (25Ø PE100 PN16)
 - CONDUIT PIPE (100Ø PVC-U PN9)
 - WATER METER - 20mm ELSTER
 - FIRE HYDRANT
 - FITTING
 - SLUICE VALVE

Registered Surveyor's certification
 I, Andrew Cridland, hereby certify that the vertical and horizontal locations, and dimensions shown on this plan are a true and correct record and were located by survey.
A. Cridland
 Registered Surveyor Reg Surveyor No.3361 Date 03/10/2018

COORDINATE DATUM NOTE:
 HORIZONTAL COORDINATES(E,N) SUPPLIED ARE MAPPING GRID OF AUSTRALIA(MGA), ZONE 56 BASED ON THE UNIVERSAL TRANSVERSE MERCATOR PROJECTION AND THE GEOCENTRIC DATUM OF AUSTRALIA 1994.
 HORIZONTAL DATUM DERIVED FROM PSM178120, E 504.738.207, N 704.3356.101.
 LEVELS SUPPLIED ARE ON THE AUSTRALIAN HEIGHT DATUM(AHD)
 LEVEL DATUM DERIVED FROM PSM178120 RL 17.324 (AHD)

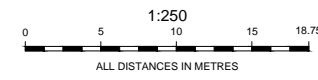

A1	INDEX	DATE	REVISIONS	DRAWN	CHECKED	PASSED
	A	03/10/2018	As-constructed details	JG	LG	

DRAWN	JG	03/10/2018
CHECKED	LG	03/10/2018
PASSED	GB	03/10/2018
INITIALS		DATE



CONSULT AUSTRALIA
 Calibre Consulting (QLD) Pty Ltd
 Level 3, 16 Innovation Parkway, Brisbane QLD Australia 4575
 Telephone 07 5314 2520 Facsimile 07 5314 2522
 Brisbane Cairns Melbourne Sydney Singapore Sunshine Coast




Unitywater
 UW2018011877
 AS-CONSTRUCTED WATER RETICULATION
 HARMONY ESTATE RELEASE 7

SHEET 3 OF 4 SHEETS	SCALE 1:250
REVISION DATE 03/10/2018	REVISION A
DISCIPLINE CODE	
DRAWING NO.	

PSM178120
 E: 504.738.207
 N: 704.3356.101
 RL: 17.324m
 1063
 303528

9008
 SP303528

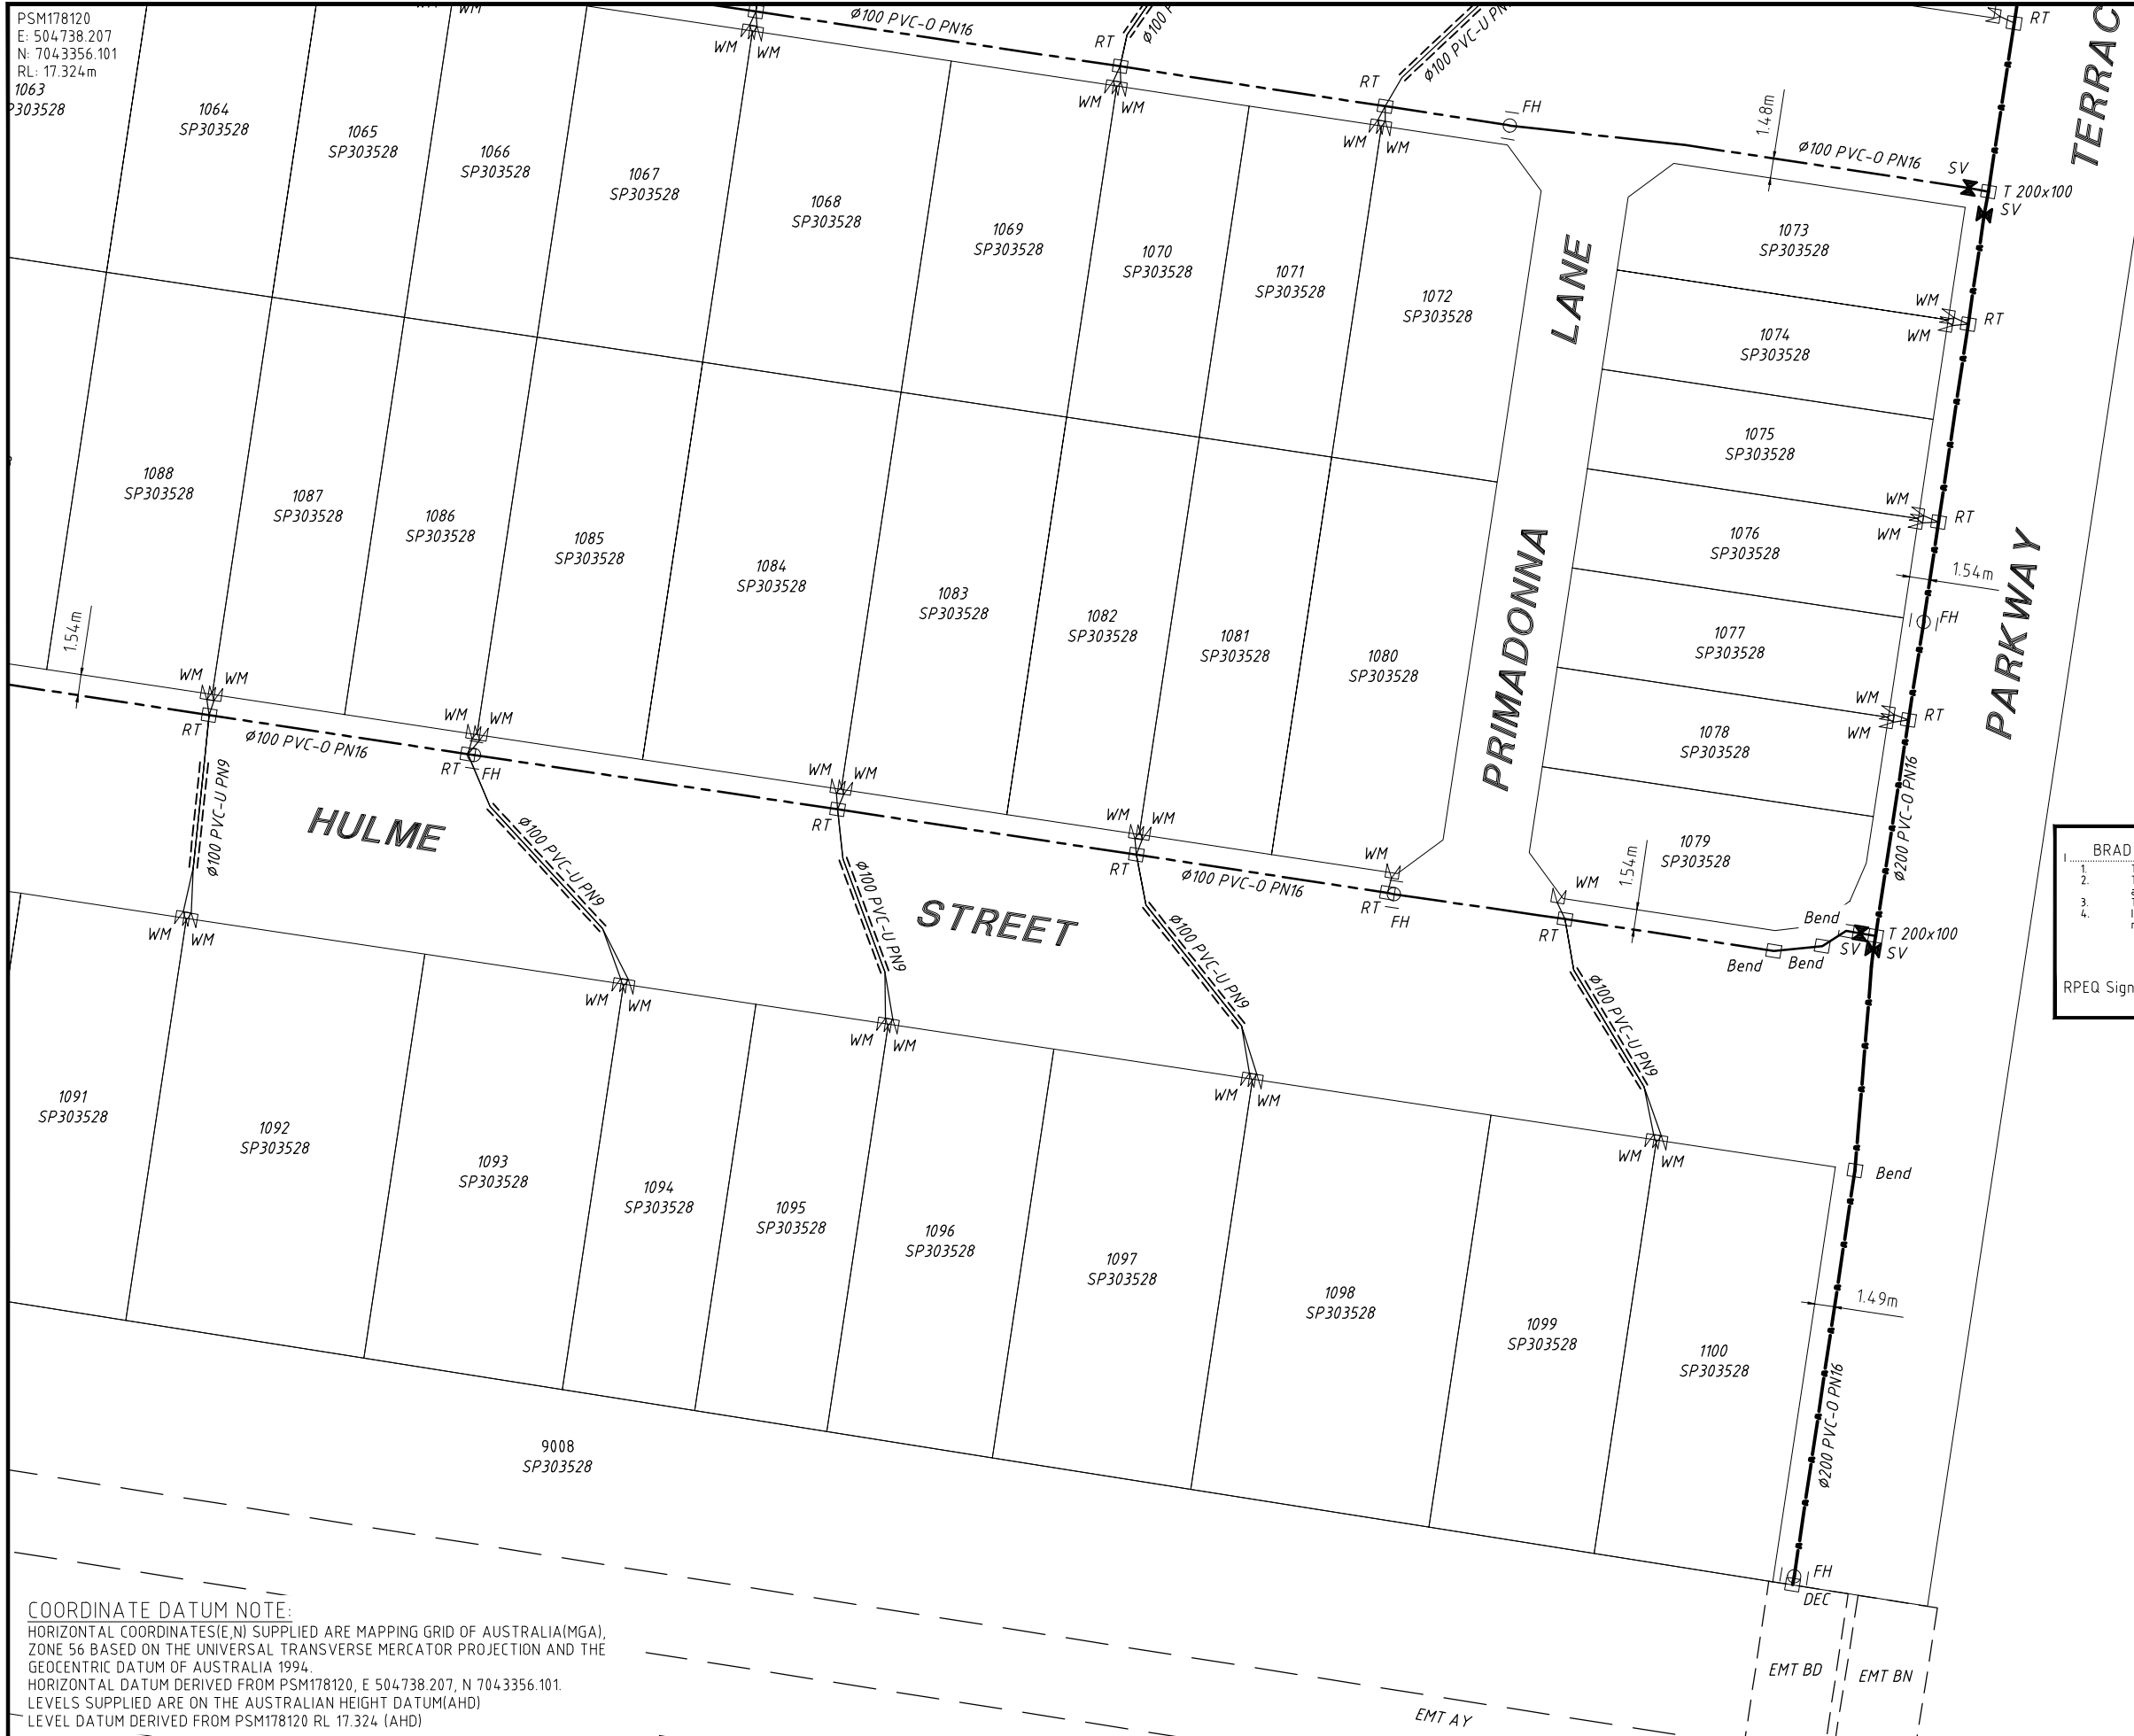

Registered Surveyor's certification
 I, Andrew Cridland, hereby certify that the vertical and horizontal locations, and dimensions shown on this plan are a true and correct record and were located by survey.

A.R. Cridland
 Registered Surveyor Reg Surveyor No.3361 Date 03/10/2018


BRAD THOMPSON ENGINEERS CERTIFICATION
 I, Brad Thompson, hereby certify that:
 1. The information contained in this drawing / document is in compliance with approved drawings and design.
 2. The new water and sewerage works defined by this drawing have been designed and constructed in accordance with the SEQ code.
 3. This represents an accurate record of as-constructed works.
 4. I accept responsibility for the information contained in this drawing / document. In accepting this responsibility we have relied upon information provided by others.

CERTIFICATION FOR HARMONY RELEASE 7

RPEQ Signature *Brad Thompson* RPEQ No. 07818 Date 01.11.18
 For and on behalf of CALIBRE CONSULTING (QLD) PTY LTD.

- LEGEND**
- — — — — EXISTING WATER MAIN
 - — — — — WATER MAIN (Ø100 PVC-O PN16)
 - — — — — WATER MAIN (Ø200 PVC-O PN16)
 - — — — — SERVICE PIPE (25Ø PE100 PN16)
 - — — — — CONDUIT PIPE (100Ø PVC-U PN9)
 - ◻ WM WATER METER - 20mm ELSTER
 - ◻ FH FIRE HYDRANT
 - ◻ FITTING
 - ◻ SV SLUICE VALVE

COORDINATE DATUM NOTE:
 HORIZONTAL COORDINATES(E,N) SUPPLIED ARE MAPPING GRID OF AUSTRALIA(MGA), ZONE 56 BASED ON THE UNIVERSAL TRANSVERSE MERCATOR PROJECTION AND THE GEOCENTRIC DATUM OF AUSTRALIA 1994.
 HORIZONTAL DATUM DERIVED FROM PSM178120, E 504.738.207, N 704.3356.101.
 LEVELS SUPPLIED ARE ON THE AUSTRALIAN HEIGHT DATUM(AHD)
 LEVEL DATUM DERIVED FROM PSM178120 RL 17.324 (AHD)

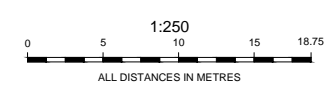

A1	INDEX	DATE	REVISIONS	DRAWN	CHECKED	PASSED	INITIALS	DATE
	A	03/10/2018	As-constructed details	JG	LG			
	DRAWN	CHECKED	PASSED	INITIALS	DATE			

calibre CONSULTING

CONSULT AUSTRALIA
 Calibre Consulting (QLD) Pty Ltd
 Level 3, 16 Innovation Parkway, Birtinya QLD Australia 4575
 Telephone 07 5314 2520 Facsimile 07 5314 2522
 Brisbane Canberra Melbourne Sydney Singapore Sunshine Coast



Unitywater

UW2018011877
 AS-CONSTRUCTED WATER RETICULATION
 HARMONY ESTATE RELEASE 7

SHEET 4 OF 4 SHEETS	SCALE 1:250
REVISION DATE 03/10/2018	REVISION A
DISCIPLINE CODE	
DRAWING NO.	